
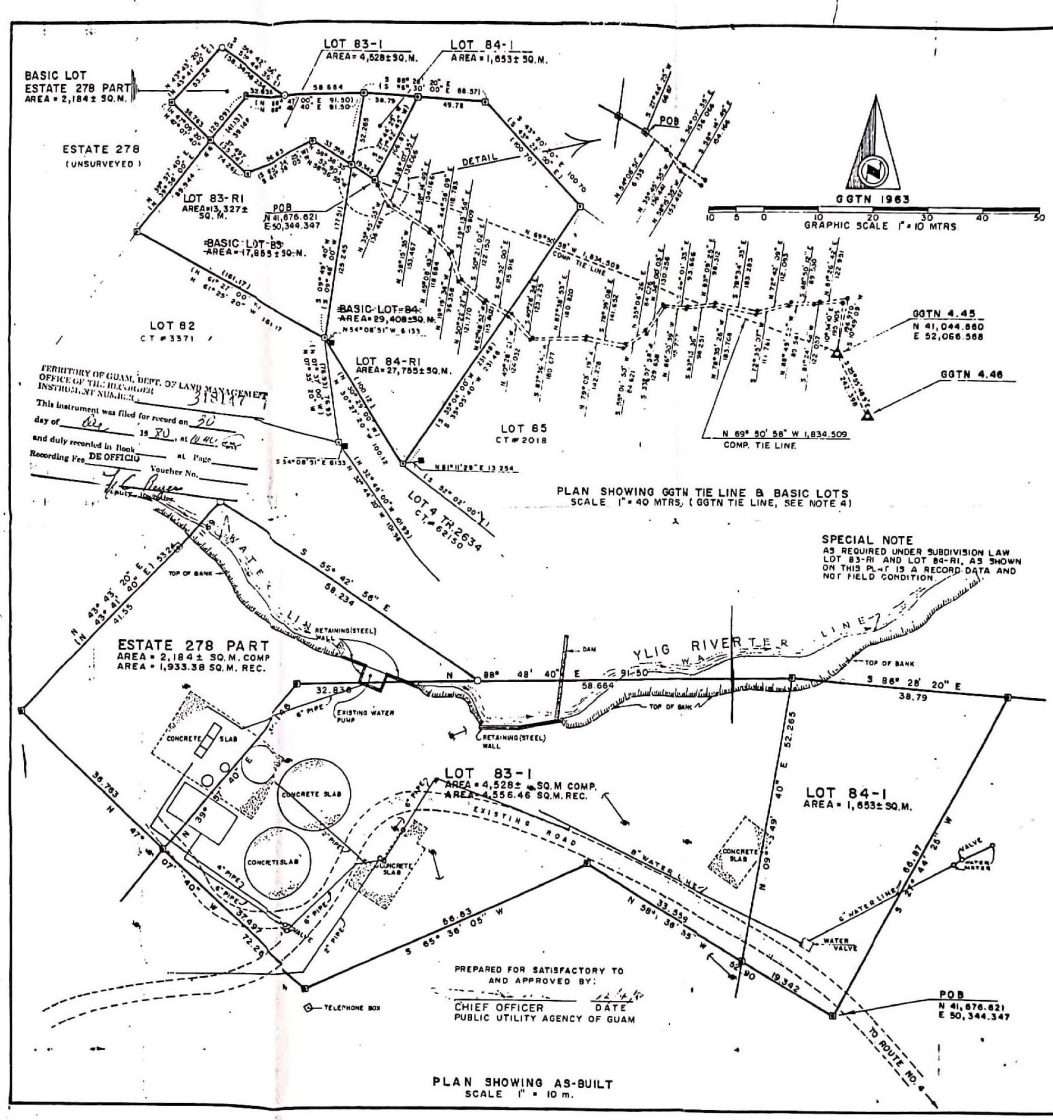


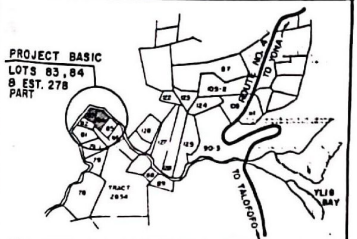

VICINITY MAP
NOT TO SCALE

SYMBOLS

- △ G G T N TRAVERSE STATIONS
- ■ CONC. MON FOUND, SET BY RLS # 23
- ● NAIL SET, TRAVERSE STATIONS
- 4" x 4" CONC. MON. SET, MARKED RLS # 48
- EXISTING POWER POLE & GUYWIRE
- CORNERS NOT SET (INACCESSABLE)

NOTES:

1. SURVEY WAS BASED ON RECOVERED CORNERS AND GGTN 4.45.
2. ALL DISTANCES ARE IN METERS, UNLESS OTHERWISE NOTED.
3. BEARING AND DISTANCE IN PARENTHESIS ARE RECORD DATA. ALL OTHERS ARE G G T N 1963
4. GGTN TRAVERSE LINE SCHEME EXAGGERATED.

REFERENCES

1. DWG. NO. 3DCO 28-0573, PARCELLING OF TRACT 2634 PREPARED BY RLS # 23, LM # 199-FY76 DOC. # 293502
2. DWG. NO. C2-527130, REAL ESTATE REQUIREMENTS YLIG FILTER & CHLORINATING PLANT, PREPARED BY GOVT. OF GUAM DATED 1952 DOC # 35548

CERTIFICATIONS:

APPROVAL PURSUANT TO CHAPTER 3, TITLE 19, GOVERNMENT CODE OF GUAM

TERRITORIAL PLANNER — DATE

THIS MAP HAS BEEN EXAMINED FOR CONFORMANCE WITH THE REQUIREMENTS OF CHAPTER 9, TITLE 14, GOVERNMENT CODE OF GUAM AND REGULATIONS THEREUNDER ON THIS 11 DAY OF Dec 1980

TERRITORIAL SURVEYOR

I, CANDIDO I. CASTRO, HEREBY CERTIFY THAT THIS MAP WAS PREPARED BY ME OR UNDER MY DIRECT SUPERVISION, THAT IT IS BASED UPON A FIELD SURVEY MADE IN AUGUST 1980 IN CONFORMANCE WITH ALL APPLICABLE LAWS AND REGULATIONS.

Dec 11, 1980
CANDIDO I. CASTRO RLS NO 48 DATE

REVISION	DATE	BRIEF DESCRIPTION	BY	APPROVED

SURVEY DATA	DATE	CANDIDO I. CASTRO
FIELD BY NIC	AUG 1980	SURVEYOR / PLANNER
BOOK NO. CC-17		RLS # 48 (GUAM) RLS # 247 (SAIPAN)
COMPUTED CIC	AUG 1980	P.O. BOX 8605, TUM. GUAM 96911 — 2nd Floor, CHALAN PIAO, SAIPAN M.I.
EXAMINED J.C.T	AUG 1980	
DRAWN J. CIC	AUG 1980	RETRACEMENT & AS-BUILT SURVEY
CHECKED BY CIC	AUG 1980	FOR
SATISFACTORY TO AND APPROVED BY		YLIG FILTER & CHLORINATING PLANT
DATE		CONSISTING OF LOTS 83-1, 84-1 & EST. 278 PART
SEE PLAN DOC #		FOR LEASE PURPOSE
LEASE GOVT GUAM 30589		MUNICIPALITY OF YONA, G.S. 28 SEC 8
L.M. CHECKED NO. 372 -FY80		BASIC LOTS 83, 84 & EST. 278 PT. — SCALE AS SHOWN
		REGISTERED ON 7-13-56/4-3-62 — SHEET 1 OF 1
		CERT OF TITLE 9269 /12426 — DRAWING NO.
		IN NAME OF TERESA C. BAZA — CC-80355Y

Scanned by CamScanner